


**Bid Items - June 2022 Billing**

R-18: Tree Protection - 2 EA  
 SW-3: Manholes - 2 EA  
 SW-11: 12" VCP - 244 LF  
 SW-17: Pre TVI Side Sewers & Culverts - 8 EA  
 SW-19: Connections - 5 EA  
 SW-21: Reconstruct Side Sewers - 18 LF  
 SW-22: Reconstruct Culverts - 55.5 LF  
 SW-23: Catch Basins - 2 EA  
 SW-27: Post TVI Side Sewers & Culverts - 3 EA

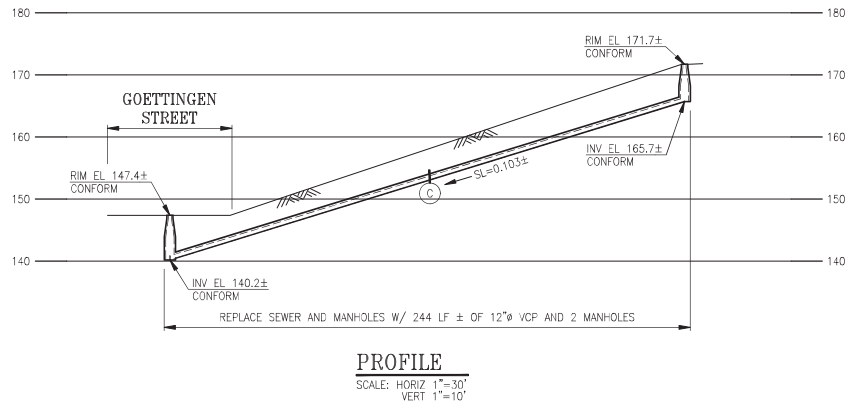

**AS BUILT  
DRAWINGS**  
 Sign *[Signature]*


**SOURCING EVENT ID: 0000003759**

CITY AND COUNTY OF SAN FRANCISCO  
**PUBLIC UTILITIES COMMISSION**  
 INFRASTRUCTURE DIVISION  
 ENGINEERING MANAGEMENT BUREAU

**VARIOUS LOCATION PAVEMENT RENOVATION  
 NO. 54 AND SEWER REPLACEMENT**

**CAMPBELL AVENUE SEWER REPLACEMENT  
 GOETTINGEN STREET TO BRUSSELS STREET  
 PLAN AND PROFILE**

ELEVATION DATUM	SEWER SIZED BY Y.W.
CITY	APPROVED BY N.B.

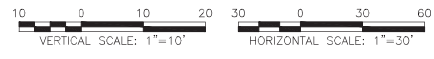

REFERENCE INFORMATION & FILE NO. OF SURVEYS
EX5721



CITY AND COUNTY OF SAN FRANCISCO <b>SAN FRANCISCO PUBLIC WORKS</b> BUREAU OF ENGINEERING			
DESIGNED L. WONG	CHECKED F. CISNEROS	DATE 07/2021	APPROVED S. HUEY
DESIGNED L. WONG	CHECKED T. WONG	DATE 07/2021	APPROVED J. HELMUTH
DESIGNED L. WONG	CHECKED J. HELMUTH	DATE 07/2021	APPROVED J. HELMUTH
DATE	DESCRIPTION	BY	APPROVED
REVISIONS			

DESIGNED / APPROVED	DRAWN	SCALE
DESIGNED / APPROVED	DESIGNED	DATE
APPROVED	APPROVED	
MANAGER, ENGINEERING MANAGEMENT BUREAU	ASSISTANT GENERAL MANAGER WATER WASTEWATER INTERFERENCE	REVISION NO.
SHEET 59 OF 75	PLAN NO. SW-9	DRAWING FILE NO. 119,176
		REVISION NO. 0