

# TRAFFIC CONTROL PLAN PW VARIOUS LOCATIONS PAVEMENT RENOVATION NO. 54 AND SEWER REPLACEMENT SEWER WORK PLAN - SOUTH VAN NESS AVE FROM HOWARD ST TO 12TH ST

Traffic Lane Requirements  
Number and Width of Lanes

STREET	TIME	NORTHBOUND	SOUTHBOUND	EASTBOUND	WESTBOUND
<b>DURING SEWER CONSTRUCTION</b>					
So. Van Ness Ave, 12 <sup>th</sup> to Howard Streets	Per Caltrans' Requirements	1 @ 14' Full Roadway	Per Caltrans' Requirements	-	-
12 <sup>th</sup> St. at So. Van Ness Ave.	At All Times	Full Roadway	Full Roadway	-	-
Howard at So. Van Ness Ave.	9AM – 4PM (M-F)	-	-	Full Roadway	Road Closed To Through Traffic Full Roadway
	At Other Times			Full Roadway	

Southbound South Van Ness Ave is part of Caltrans right-of-way. A Caltrans Encroachment Permit may be required


Additional traffic control requirements and/or work hour restrictions from Caltrans may apply.

- ☒ NO EXCEPTIONS TAKEN
- ☐ MAKE CORRECTIONS NOTED
- ☐ REJECTED
- ☐ REVISE AND RESUBMIT
- ☐ SUBMIT SPECIFIED ITEM(S)

Review is only for general conformance with the design concept of the project and general compliance with the requirements of the contract documents. Any action shown is subject to the requirements of the plans and specifications. Contractor's responsibilities include, but are not limited to actual dimensions which shall be confirmed and correlated at the job site; preferred fabrication processes and techniques of construction; coordination of the contractor's work with that of all other trades; and the satisfactory performance of the contractor's work.


Sustainable Streets Division  
San Francisco Municipal Transportation Agency  
City and County of San Francisco

By [Signature] Date 09/23/2022

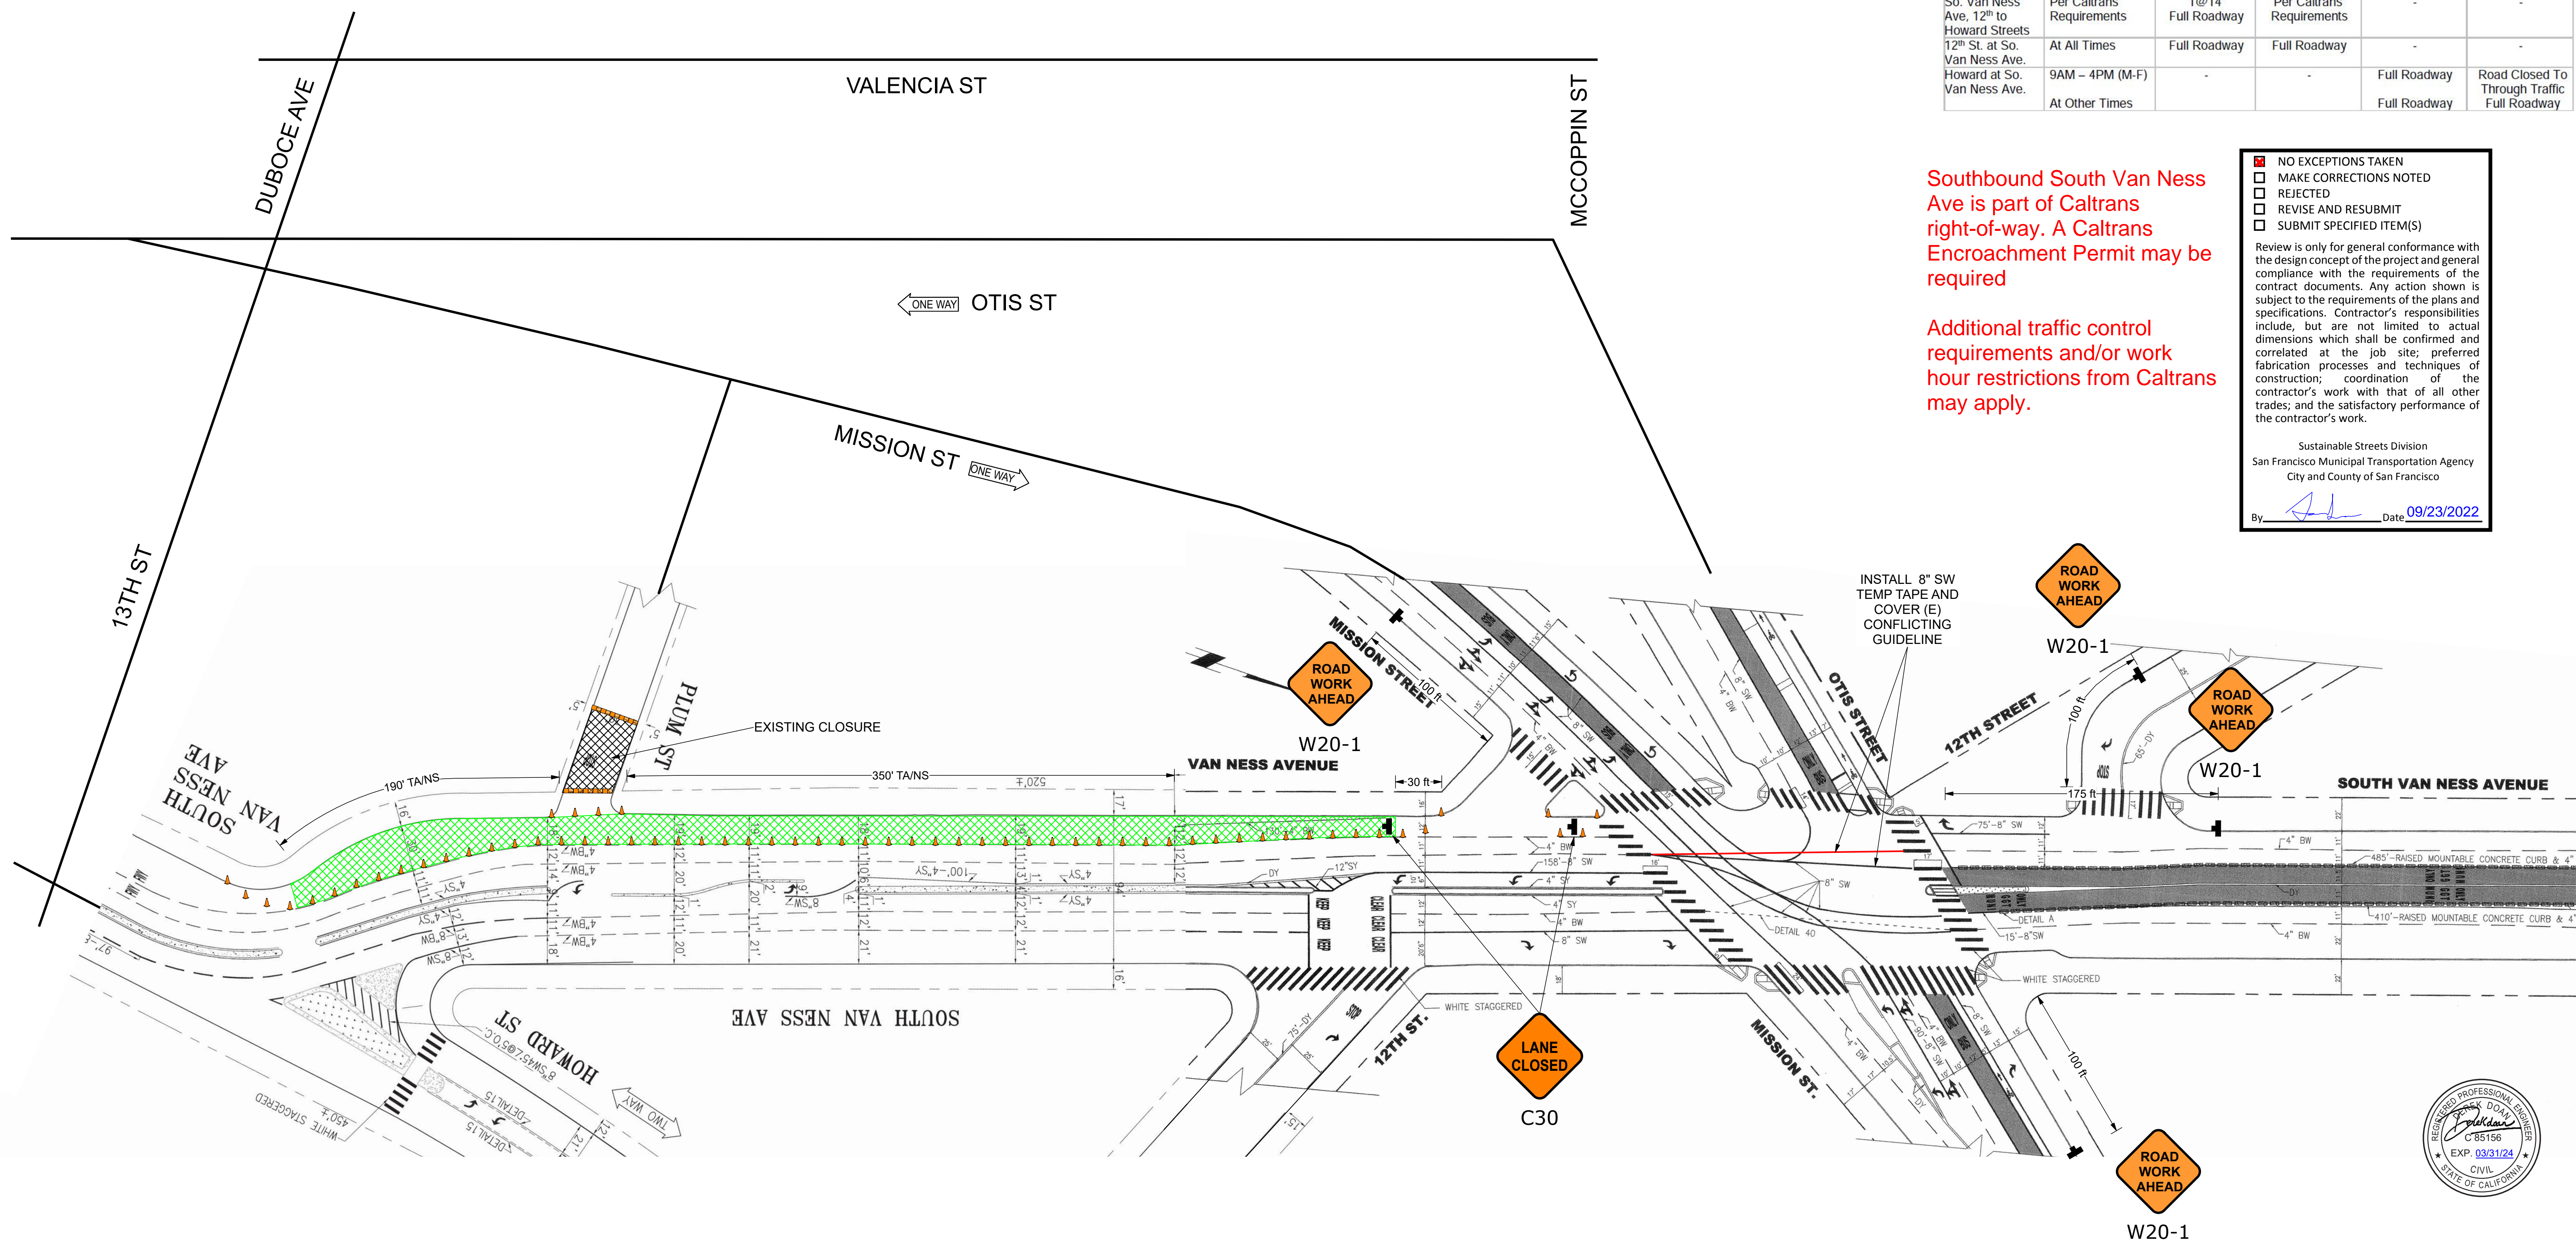

## LEGEND

- |  |                                  |  |                                  |
|--|----------------------------------|--|----------------------------------|
|  | Flashing Arrow Board             |  | Bus Stop                         |
|  | Flashing Arrow Board (Plan View) |  | Concrete K-Rail Barrier          |
|  | Portable Flashing Beacon         |  | Water Filled Barrier             |
|  | Type I Barricade                 |  | Not To Scale                     |
|  | Type III Barricade               |  | Tow-Away/No Stopping             |
|  | Type III Barricade (Plan View)   |  | Parking Control / Police Officer |
|  | 28" Traffic Cone                 |  | Flagger                          |
|  | Pedestrian Barricade             |  | Equipment                        |
|  | Work Area                        |  | Pipe to be installed             |
|  | Sign and Stand                   |  | Fixed Mounted Channelizers       |

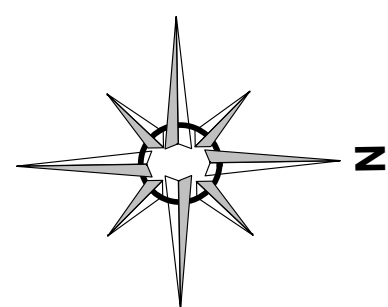

Plan Scale

1" = 50'

Table 6C-1. Recommended Advance Warning Sign Minimum Spacing

Road Type	Distance Between Signs**		
	A	B	C
Urban <i>freeway</i> : 25 mph or less***	100 feet	100 feet	100 feet
Urban <i>more than 25 mph to 40 mph***</i>	250 feet	250 feet	250 feet
Urban <i>more than 40 mph***</i>	350 feet	350 feet	350 feet
Rural	500 feet	500 feet	500 feet
Expressway / Freeway	1,000 feet	1,000 feet	2,000 feet

\* *Approved only for use on the Interstate and State Route systems.*  
\*\* The column headings A, B, and C are the dimensions shown in Figures 6B-1 through 6B-4. The A dimension is the distance from the transition or point of restriction to the first sign. The B dimension is the distance between the first and second signs. The C dimension is the distance between the second and third signs. (The "first sign" in the sign is a three-sign series that is closest to the TTC zone. The "third sign" in the sign that is furthest upstream from the TTC zone.)  
\*\*\* Posted speed limit, off-peak 85th-percentile speed prior to work starting, or other anticipated operating speed in mph.

Table 6F-10(CA). Maximum Spacing of Channelizing Devices

Speed (mph)	Maximum Channelizing Devices Spacing		
	Taper* (feet)	Tangent (feet)	Conflict** (feet)
20	20	40	10
25	25	50	12
30	30	60	15
35	35	70	17
40	40	80	20
45	45	90	22
50	50	100	25
55	50	100	25
60	50	100	25
65	50	100	25
70	50	100	25
75	50	100	25

\* Maximum channelizing device spacing for all speeds on one-lane/two-way tapers is 20 feet. Maximum channelizing device spacing for all speeds on downstream tapers is 20 feet. All other tapers are as shown.  
\*\* Use on intermediate and short-term projects for taper and tangent sections where there are no pavement markings or where there is a conflict between existing pavement markings and channelizing devices.

Table 6C-3(CA). Taper Length Criteria for Temporary Traffic Control Zones (for 12 feet Offset Width)

Speed S (mph)	Minimum Taper Length** for Width of Offset 12 feet (ft)			
	Merging L (feet)	Shifting L/2 (feet)	L/3 (feet)	Down Stream (feet)***
20	40	40	27	50
25	125	63	42	50
30	180	90	60	50
35	245	123	82	50
40	320	160	107	50
45	340	270	180	50
50	600	300	200	50
55	600	300	220	50
60	720	380	240	50
65	780	380	260	50
70	840	430	280	50
75	900	450	300	50

\* Posted speed limit, off-peak 85th-percentile speed prior to work starting, or the anticipated operating speed in mph.

\*\* For other offsets use the following merging taper length formula for L: For speeds of 40 mph or less, L=WS/50 For speeds of 45 mph or more, L=WS

Where: L = taper length in feet W = width of offset in feet S = posted speed limit, off-peak 85th-percentile speed prior to work starting, or the anticipated operating speed in mph

\*\*\* Maximum downstream taper length is 100 feet. See Section 6C.08.



3450 3RD ST #3G  
SAN FRANCISCO, CA 94124  
415-206-1700 PHONE  
415-206-1711 FAX  
INFO@CMCTRAFFIC.COM

LICENSE NO 792059  
CLASS A, 31, C21  
WBE/SBE/LBE/DBE CERTIFIED  
WWW.CMCTRAFFIC.COM

Date: 09/20/2022 Author: WY/DD Project: VARIOUS LOCATIONS NO. 54  
Client: PRECISION Location: SAN FRANCISCO TCP: 005  
Job #: 3128 Rev: 1

## Comments:

- 1) WORK HOURS: SEE TRAFFIC LANE REQUIREMENTS
- 2) CONTRACTOR TO VERIFY EXISTING STRIPING IS ACCURATE PRIOR TO START OF WORK.
- 3) ALL TRAFFIC CONTROL SHALL CONFORM TO THE LATEST EDITION OF THE CA MUTCD.
- 4) ALL TRAFFIC CONTROL DEVICES SHALL BE RETROREFLECTIVE IF SETUP DURING HOURS OF DARKNESS.
- 5) MAINTAIN LOCAL ACCESS TO BUSINESSES AND RESIDENTS AT ALL TIME.
- 6) THE CONTRACTOR SHALL PERFORM THE APPROPRIATE MEASURES TO ENSURE THE SAFETY OF BICYCLISTS ON ALL STREETS ON WHICH THERE IS CONSTRUCTION.
- 7) THE CONTRACTOR SHALL NOT PREVENT OR DELAY THE OPERATION OF MASS TRANSIT VEHICLES AT ANY TIME.